



PREPARED BY  
RECORDED BY  
CHECKED BY  
PLATE NO. 83-R-1-2

DETAILED RECORD PLAN  
AUXILIARY INTAKE  
RAMANGA RIVER PROJECT  
IRIGATION DEPARTMENT/UTAR PRADESH

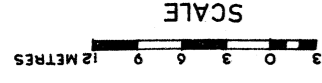

NOTES:  
1 ALL DIMENSIONS ARE IN MM. AND ELEVATIONS IN METRES.  
2 CHANGES SHOWN IN AS EXECUTED DRAWINGS SUBMITTED FROM FIELD DIVISIONS HAVE BEEN INCORPORATED.

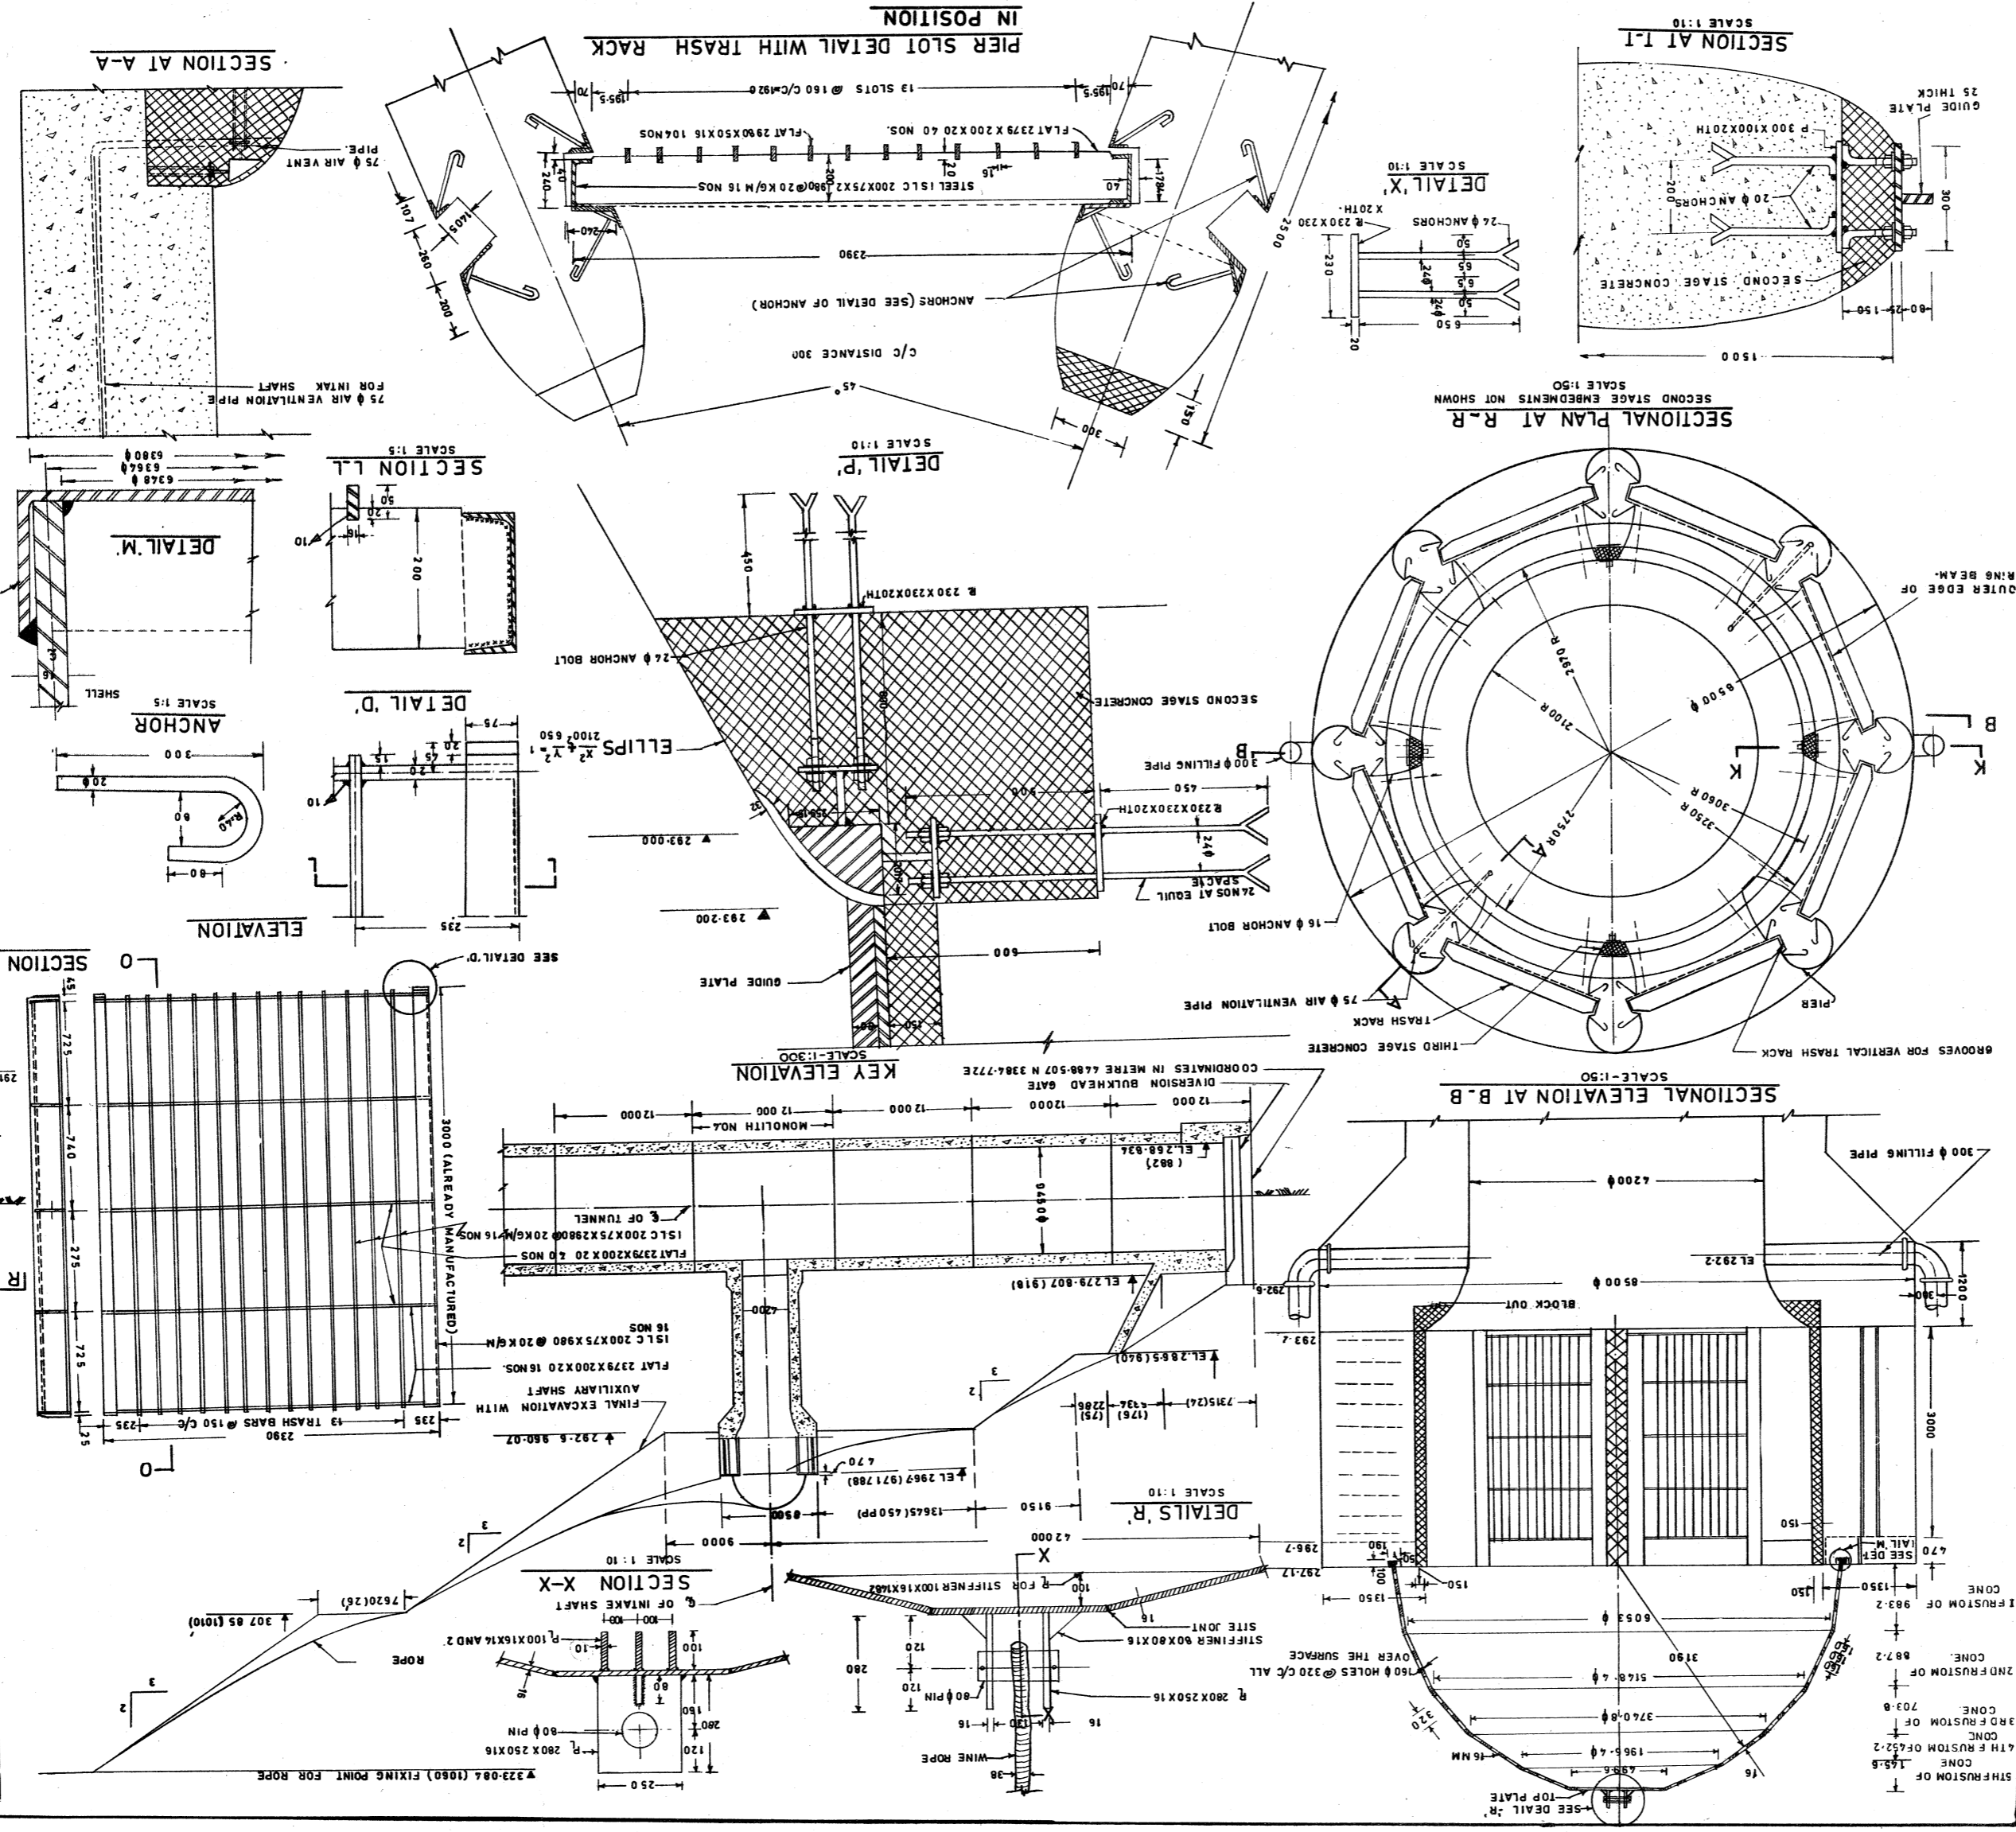

HALF SECTIONAL ELEVATION OF K-K (FILLING PIPE NOT SHOWN) SCALE 1:25

ELEVATION

SECTION O-O

DETAIL P

ANCHOR SCALE 1:5

DETAIL M

SECTION L-L

SCALE 1:5

DETAIL D

SCALE 1:5

SCALE 1:10

SCALE 1:10

