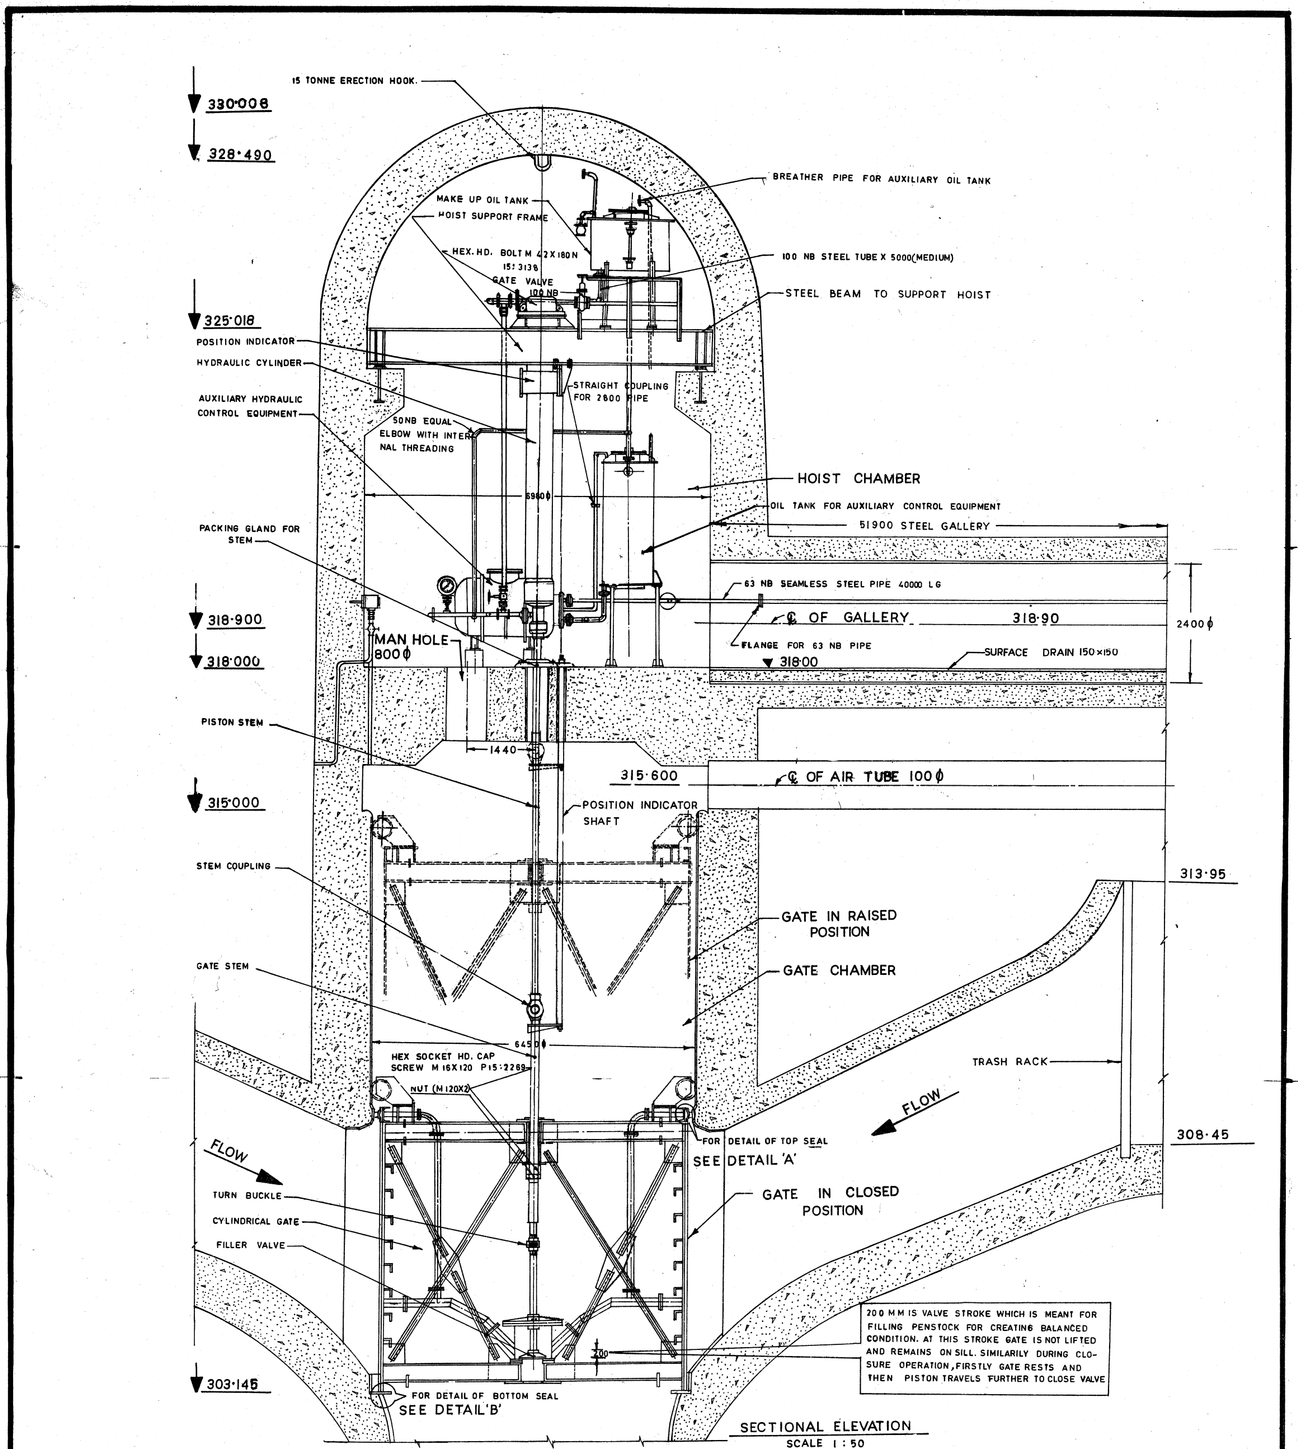

SECTIONAL ELEVATION
SCALE 1 : 50

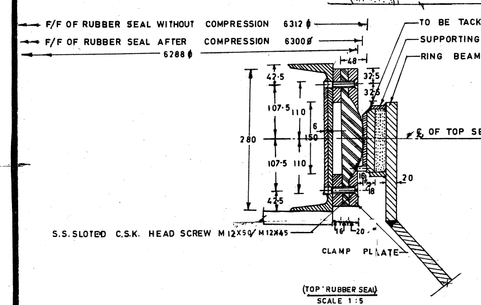

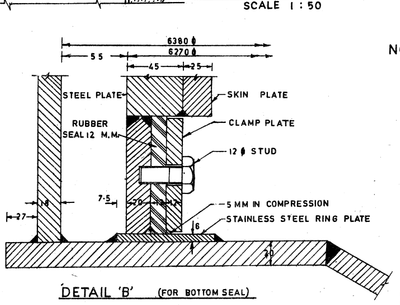

NOTES :-
ALL DIMENSIONS ARE IN M.M. AND ELEVATIONS IN METRES.

RECORD PLAN
RAMGANGA RIVER PROJECT
IRRIGATION DEPARTMENT UTTAR PRADESH
POWER INTAKE _ CYLINDRICAL GATE
GENERAL INSTALATION
SHEET 1 OF 2

PREPARED BY D/MAN	SUBMITTED BY S.E.
CHECKED BY COMPUTOR A.E.	RECORDED BY S.E.I.C.C.

PLATE NO. 80-R-PI-12